

NOTE:  
 THIS RECORD DRAWING GENERALLY REFLECTS THE POSITION OF CONSTRUCTED FACILITIES BASED ON INFORMATION PROVIDED BY TIFFANY CONSTRUCTION AND CONTRACTOR REDLINES AND FIELD SURVEY DATA. USERS OF THIS INFORMATION ARE ADVISED TO OBTAIN INDEPENDENT VERIFICATION OF ACTUAL CONDITIONS PRIOR TO EXCAVATION.

CALL TWO WORKING DAYS BEFORE YOU DIG  
**1-800-STAKE-IT**


| REVISIONS |             |      |    |
|-----------|-------------|------|----|
| NO.       | DESCRIPTION | DATE | BY |
|           |             |      |    |
|           |             |      |    |
|           |             |      |    |

**SWI**  
 Shephard Wesnitzer, Inc.

75 Kollof Place  
 Sedona, AZ 86336  
 928.282.1061  
 928.282.2058 fax  
 www.swiaz.com

JOB NO: 10180 (11346)  
 DATE: MAY 13  
 SCALE: 1"=20'  
 DRAWN: RJC  
 DESIGN:  
 CHECKED: TKH

BARBARA ANTONSEN PARK  
 SEDONA ARIZONA  
**RECORD DRAWING**

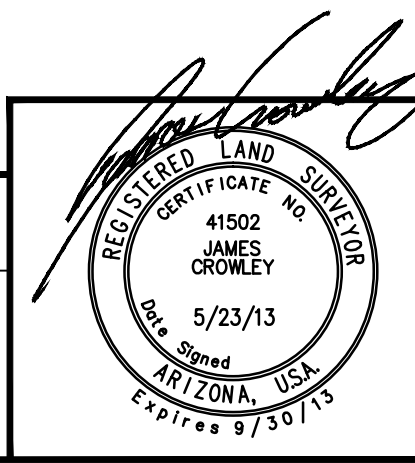

DRAWING NO.  
**R1**  
 SH1 NO. OF  
 1 1